



عنايه الكابتن محمد الرلابي  
صفحات

Ref : \_\_\_\_\_

الرقم : ٣ / ٤ / ١٢

Date : \_\_\_\_\_

التاريخ : ٢٠١٦ / ١ / ٥

عطوفة مدير عام مؤسسة الموانئ المحترم

المشروع: ميناء العقبة الجديد

الموضوع: انتهاء تجهيز رصيفي (3و4) للتشغيل من قبل المؤسسة

تحية طيبة وبعد،،

اشارة لمحضر اجتماع اللجنة المشتركة رقم (90) تاريخ 2015/8/12 بخصوص استخدام رصيف رقم (3 و4) في ميناء العقبة الجديد، يرجى العلم أنه قد تم تجهيز متطلبات التشغيل لهذه الارصفة من نقل وتركيب للقبان وانارة المنطقة عن طريق مولد كهربائي بالإضافة إلى توريد وتركيب وحدات صحية وتجهيز المكاتب بالأثاث اللازم حسب ما تم الاتفاق عليه مع كوادركم المعنية، وعليه أرفق طيه مواصفات الرصيفين رقم (3 و4) والمبينة في المخططات المرفقة وكما يلي:

- طول الرصيفين (3 و4): 320 متر
- الغاطس: 10.0 متر
- الطاقة الاستيعابية للأرصفة للبواخر: (60,000-10,000) DWT

للعلم وإجراء اللازم لتشغيل الرصيفين أصولياً وبالتنسيق مع الجهات المعنية.

وتفضلوا بقبول فائق الاحترام ،،

المهندس غسان أسعد غانم

الرئيس التنفيذي

غانم


المرفقات: - مخطط لمواصفات الرصيفين (3 و4)

- مرفق مخطط للعلم يبين مواصفات رصيف (2و1)

نسخة/ المدير التنفيذي لتطوير وإنشاء الموانئ

غانم

Scale: 1:1000  
 Date: 15/05/2014  
 Project: AS-BUILT - Copelina to Copelina

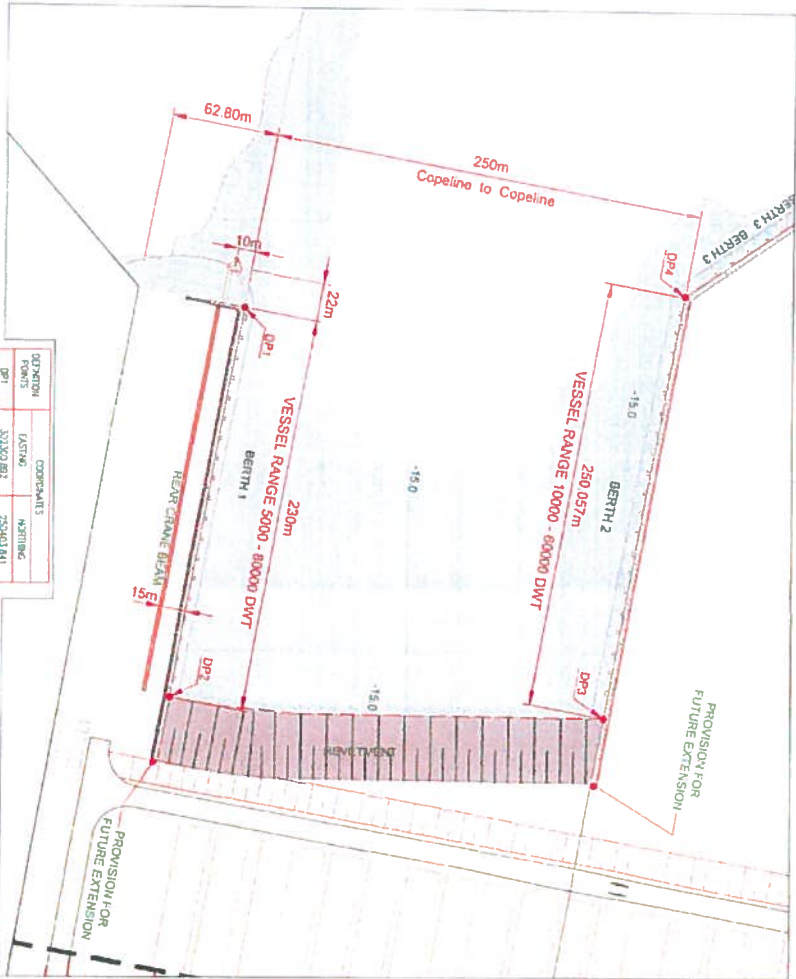


MOORING POINTS	COORDINATES
DP1	30200.881 25300.841
DP2	30207.043 25311.971
DP3	30233.419 25304.144
DP4	30292.282 25299.154



Scale: 1:1000  
 Date: 15/05/2014  
 Project: AS-BUILT - Copelina to Copelina

**AS-BUILT**

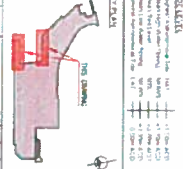


AS-BUILT - Copelina to Copelina  
 PROJECT: AS-BUILT - Copelina to Copelina

Client: **ADM**  
 Consultant: **MA&G**

Project: **AS-BUILT - Copelina to Copelina**

Scale: 1:1000  
 Date: 20/11/2024  
 Project: Concept Design Berth Plan


DEFINITION	COORDINATES	NORTHING
POINTS	EASTING	
BP1	327203.202	250014.144
BP4	327202.202	250009.624
BP3	327111.064	250013.203

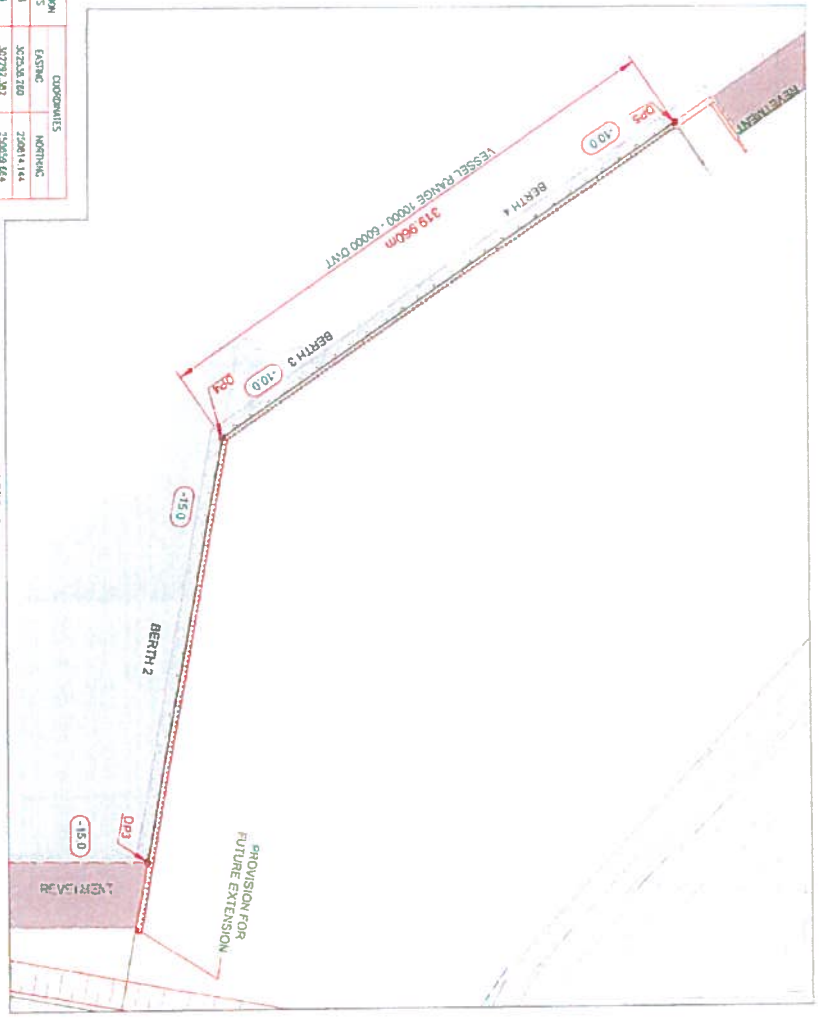

BERTH 3 & 4  
 CONCEPT DESIGN  
 BERTH PLAN

NOTES  
 1. ALL DIMENSIONS ARE IN METERS UNLESS OTHERWISE SPECIFIED.  
 2. THE PLAN IS FOR CONCEPT DESIGN ONLY AND IS NOT TO BE USED FOR CONSTRUCTION.

AS-BUILT

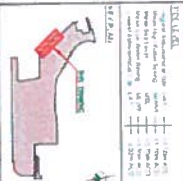

PROJECT: BERTH 3 & 4  
 CLIENT: [Name]  
 DATE: 20/11/2024

Logos for project partners and consultants, including BIM, and a table with project details.

Project No.	2024/01/001
Revision	01
Author	ALPINE MCA-1000
Date	20/11/2024